Asbuilt 36" x 78.29 CMP @ 243+08.54

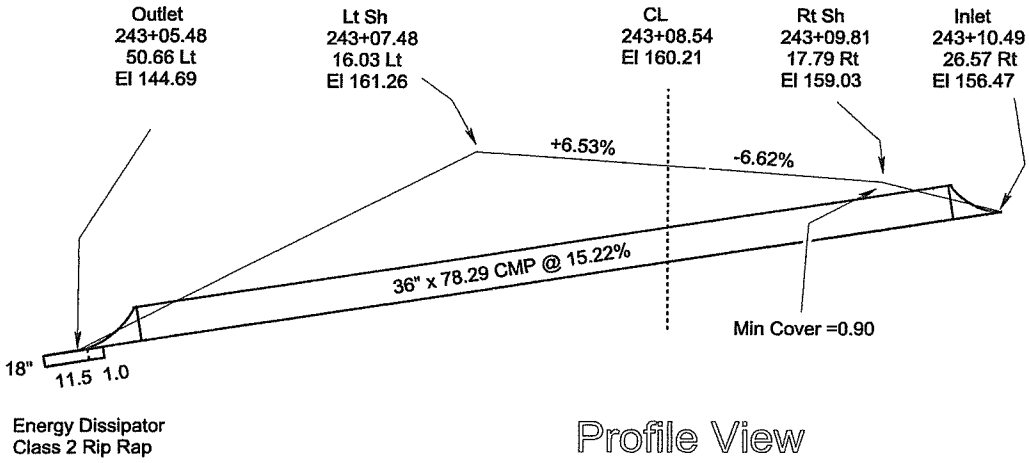

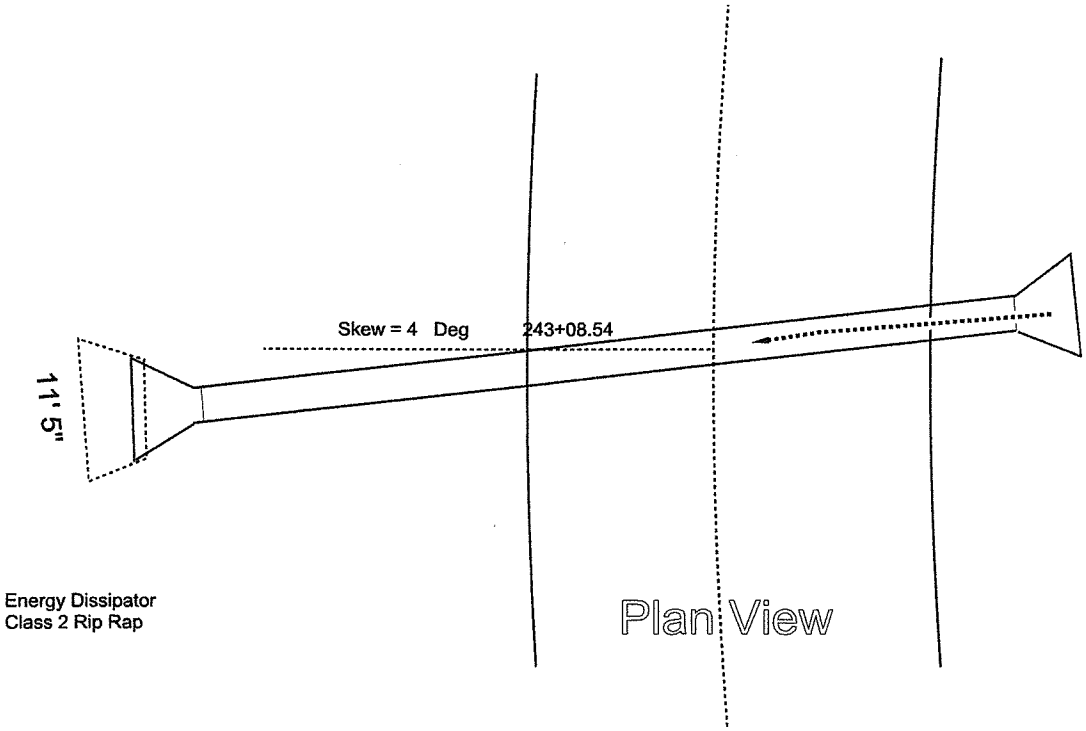

Notes:
1. ~~78.29 CMP Includeds End Sections @ 5' Each~~
2. 1 Energy Dissipator
3. Template = Subgrade Elevations

Submitted By:
Drawn By: DM
8-10-2008
Revised 8-26-2008 (New Data)

15' 0 15' 30'